



OPTUS 2.4m HIGH CHAINWIRE SECURITY FENCE WITH 1.5m WIDE SINGLE ACCESS GATE. REFER TO DRAWING OSD-140 FOR DETAILS

OPTUS 75mm THICK SINGLE SIZE GRAVEL/RECYCLED CONCRETE OVER WEED MAT WITH TIMBER EDGING. REFER TO OSD-010 FOR MATERIAL DETAILS AND OSD-140 FOR TIMBER EDGING DETAILS

OPTUS 200mm HIGH TIMBER STEPS. REFER TO DRG. H8097-S1 FOR DETAILS

INSTALL NEW VODAFONE NOKIA AYGE GPS ANTENNA (1 OFF) ON THE TOP OF SHELTER WALL. ENSURE MIN. 500mm HORIZONTAL SEPERATION FROM OTHER GPS ANTENNA

REPLACE EXISTING OPTUS GPS ANTENNA (1 OFF) WITH NEW OPTUS ERICSSON GNSS GPS ANTENNA (1 OFF) ON THE TOP OF SHELTER WALL

OPTUS HDPE ELECTRICAL DRAW PIT

OPTUS SUB-MAINS IN U/G FROM SITE GROUP METER BOX. REFER TO DRG'S H8097-E1 AND E2 FOR DETAILS

OPTUS 1.5m WIDE SINGLE ACCESS GATE

REFER TO ANTENNA LAYOUT FOR UPGRADE

EXISTING TELSTRA FENCE

TELSTRA SUB-MAINS FROM SITE GROUP METER. REFER TO DRG'S H8097-E1 & E2 FOR DETAILS

SITE GROUP METER BOX ON FREE STANDING "H" FRAME TO HOST OPTUS METER AND TELSTRA ONE WITH ACCESSORIES. REFER TO METASITE STANDARD

EXISTING TELSTRA EQUIPMENT SHELTER

SITE CONSUMER MAINS IN U/G CONDUIT. APPROX. 260m. REFER TO DRG'S H8097-E1 AND E2 FOR DETAILS

OPTUS SITE ACCESS ROUTE

OPTUS EQUIPMENT SHELTER SUPPORTED ON STRIP FOOTINGS AND PIERS. REFER TO DRG. H8097-S1 FOR FOOTING DETAILS

EXISTING OPTUS ZONECOOL C3 EQUIPMENT SHELTER TO BE RECONFIGURED TO ACCOMODATE EXISTING & PROPOSED EQUIPMENTS. REFER TO DRG. H8097-F1 FOR DETAILS

REUSE EXISTING VODAFONE H&S 9/18 HYBRID CABLE (1 OFF) (LENGTH: 40m) AND INSTALL NEW H&S 9/18 (10mm²) HYBRID CABLES (1 OFF) (LENGTH: 40m) FOR VODAFONE TO RUN IN EXISTING OPTUS 450mm WIDE CABLE LADDER

REUSE EXISTING OPTUS H&S 9/18 HYBRID CABLE (1 OFF) (LENGTH: 40m) AND SHARED H&S 9/18 HYBRID CABLE (1 OFF) (LENGTH: 40m) TO BE ALLOCATED TO OPTUS TO RUN IN EXISTING OPTUS 450mm WIDE CABLE LADDER

EXISTING OPTUS 27m HIGH ROCLA (SR3-BM27-585) CONCRETE MONOPOLE

EXISTING OPTUS 600DIA PARABOLIC ANTENNA (1 OFF)

REMOVE EXISTING VODAFONE HUAWEI RRU3952 (L850) (3 OFF), RRU3953 (U9) (3 OFF), RRU3971 (L18) (3 OFF) & RRU3971 (L21) (3 OFF). INSTALL NEW VODAFONE NOKIA RRU AHPB (N7) (1 OFF PER SECTOR, 3 OFF TOTAL), AHCA (L850) (1 OFF PER SECTOR, 3 OFF TOTAL) AND AHEGG (18/21) (2 OFF PER SECTOR, 6 OFF TOTAL) ON NEW RRU MOUNT CONNECTED TO NEW COLLAR MOUNT

REMOVE EXISTING OPTUS HUAWEI RRU3262 (L7) (3 OFF), RRU3936 (U9) (3 OFF), RRU3971 (L18) (3 OFF), RRU3971 (L21) (3 OFF) & RRU3281 (L26) (3 OFF). INSTALL NEW OPTUS ERICSSON RRU4480 (L7/NL9) (1 OFF PER SECTOR, 3 OFF TOTAL), RRU4466 (L18/NL21/L26) (1 OFF PER SECTOR, 3 OFF TOTAL) AND FUTURE RRU (2 OFF PER SECTOR, 6 OFF TOTAL) ON NEW RRU MOUNT CONNECTED TO NEW COLLAR MOUNT

REPLACE EXISTING eJV 12P HUAWEI ASI4517R1 PANEL ANTENNAS (3 OFF) WITH NEW eJV 16P COMMSCOPE RRVV2VV-6533D-R8 PANEL ANTENNAS (1 OFF PER SECTOR) (FOR SECTOR 11-J, 21-J, & 31-J) ON NEW ANTENNA MOUNT CONNECTED TO NEW COLLAR MOUNT

REMOVE EXISTING VODAFONE COMBINERS COM2 (E12F03P18) (3 OFF) & COM4 (E14F05P17) (6 OFF). INSTALL NEW VODAFONE COMBINER COM2g (E14F06P81) (1 OFF PER SECTOR, 3 OFF TOTAL) BEHIND NEW PANEL ANTENNAS ON NEW MOUNT

INSTALL NEW OPTUS ERICSSON AIR3268 B78Y (NR35) ANTENNAS (1 OFF PER SECTOR) (FOR SECTOR 12-O, 22-O, & 32-O) ON NEW ANTENNA MOUNT CONNECTED TO NEW COLLAR MOUNT

INSTALL NEW VODAFONE NOKIA AVQL (NR36) ANTENNAS (1 OFF PER SECTOR) (FOR SECTOR 13-V, 23-V, & 33-V) (BELOW OPTUS AAU) ON NEW ANTENNA MOUNT CONNECTED TO NEW COLLAR MOUNT

REPLACE EXISTING COLLAR MOUNT WITH NEW COLLAR MOUNT. REFER TO DRG. H8097-SX FOR DETAILS

REMOVE EXISTING OPTUS COMBINERS COM2a (E12F13P25) (3 OFF) & COM3 (E16V90P56) (6 OFF). INSTALL NEW OPTUS REJ FILTER (E14V00P21) (1 OFF PER SECTOR, 3 OFF TOTAL) BEHIND NEW PANEL ANTENNAS ON NEW MOUNT

ANTENNA LAYOUT SCALE 1:50

DETAIL 1 SCALE 1:100 G2

MGA ZONE	55
E	520 051
N	5 263 789
AT	€ MONOPOLE

Rev	Date	Revision Details	Consultant	CAD	Designer	Verifier	Approver
A	13.09.25	ISSUED FOR CONSTRUCTION (SG UPGRADE (eJV))	ALL TELECOMS	RN	SS	GL	JM
AB	09.04.21	AS BUILT	METASITE	AU	JB	GC	PJ
A	28.06.18	ISSUED FOR CONSTRUCTION (EJV GREENFIELD PROJECT)	METASITE	JM	JB	GC	PJ



Client:

Project:

MOBILE NETWORK AUSTRALIA
SITE No:- H8097
AUSTINS FERRY
2 PLAN 158154 WAKEHURST ROAD

Drawing Title:

SITE LAYOUT AND SETOUT PLAN

Drawing Status:

FOR CONSTRUCTION

Drawing No.

H8097-G3


Revision

A

REMOVE

1. REFER TO DRAWING **H8097** -A1 FOR ANTENNA SYSTEM CONFIGURATION.
2. REFER TO DRAWING **H8097** -G1 FOR STRUCTURAL CERTIFICATION NOTES.
3. REFER TO DRAWING **H8097** -G3 FOR ADDITIONAL NOTES.
4. ALL MHA's, COMBINERS AND ASSOCIATED ANCILLARIES TO BE INSTALLED BEHIND ANTENNAS ON **NEW MOUNT**

NOTE:
THIS DRAWING IS DIAGRAMMATIC ONLY
AND SHOULD NOT BE SCALED.

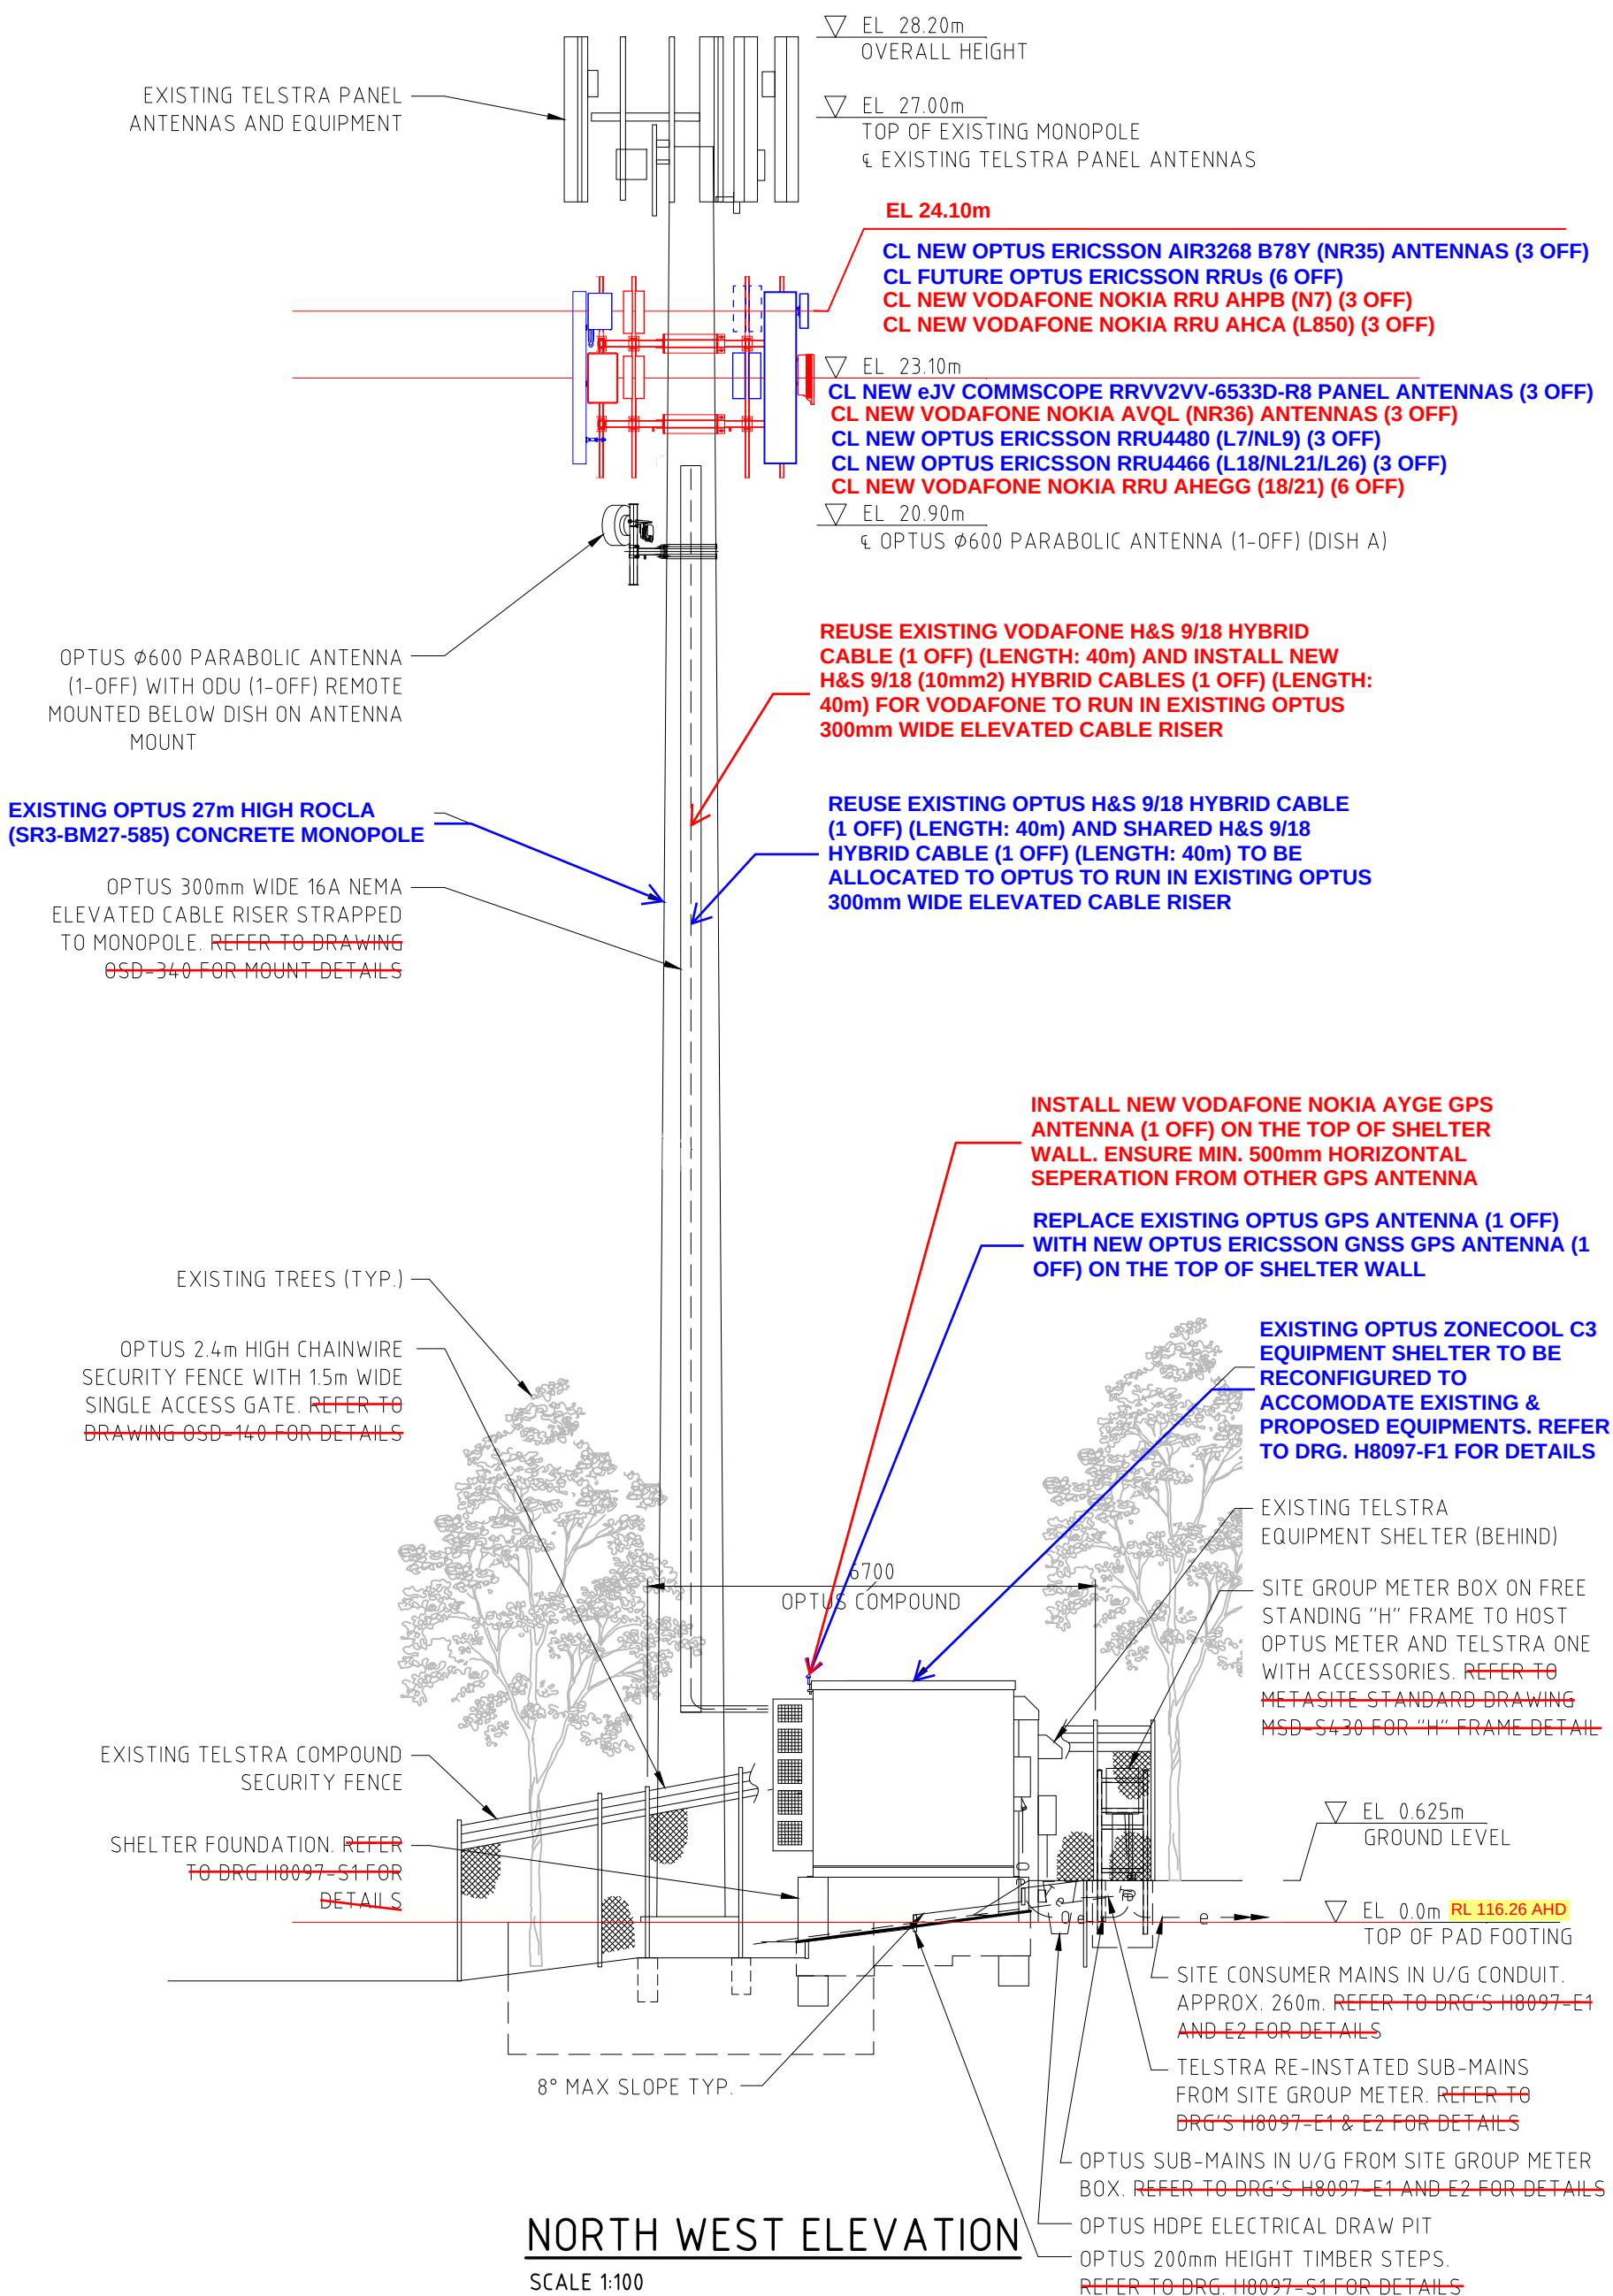

DFC NOTE: RACK STANDARD SIZES NEED TO BE UPDATED AS PER PHOTOS

SHELTER DETAILS:

1. INTERNATIONAL COMMUNICATIONS SHELTERS (ICS) ZONECOOL TYPE C3 SANDWICH PANEL SHELTER, COLOURED COLORBOND "PALE EUCALYPT".

OPTUS NOTES:

1. REMOVE EXISTING OPTUS HUAWEI BBU AND DCDU FROM THE RACK AT G001F04.
2. INSTALL NEW 1 x ERICSSON BBU6672 FOR L7/NL9/L18/NL21/L26/NR35 IN RACK AT G001F04.
3. INSTALL NEW DCDU (1 OFF) TO POWER UP ERICSSON BBUs IN RACK AT G001F04.
4. ALL EXTERNAL ALARMS (ENVIRONMENTAL ETC) TO BE MIGRATED FROM UMTS BBU TO LTE/5G BBU, AS PER OPTUS STANDARDS, INCLUDING OM36991 RAN EQUIPMENT I&C STANDARDS.
5. ALL 3G CONTROLLED RET'S TO BE MIGRATED TO 4G/5G AS REQUIRED, ACCORDING TO OPTUS STANDARDS, INCLUDING OM38040 MIMO PORT PLUMBING BTS RET CONTROL DEPLOYMENT.
6. REMOVE ANY ON-SITE CCU'S AND CONVERT CCU CONTROLLED MHA'S TO BTS CONTROLLED
7. EXISTING KRONE PANEL TO BE UPGRADED TO RJ45 PATCH PANEL. INSTALL 1 x 6610 FOR PSU ALARM AT G000.F02.

iDCDP NOTES:

8. REUSE EXISTING OPTUS 22-WAY LENMIC iDCDP (1 OFF) IN RACK AT G001F05. AND SWAP CBs ON PSU AND iDCDP AS PER LATEST GUIDELINE.

HYBRID CABLE NOTES:

9. REUSE EXISTING OPTUS H&S 9/18 HYBRID CABLE (1 OFF) (LENGTH: 40m) AND SHARED H&S 9/18 HYBRID CABLE (1 OFF) (LENGTH: 40m)

DC POWER UPGRADE:

10. REMOVE EXISTING OPTUS HUAWEI PSU (1 OFF) WITH EXISTING 3kW RECTIFIERS (6 OFF) AND LPFG12-100S BATTERY STRINGS (5 OFF) FROM THE RACK AT G000F03.
11. INSTALL NEW OPTUS 27kW VERTIP PSU WITH NEW 3kW RECTIFIERS (6 OFF) AT G000F03.
12. INSTALL NEW LFeLi-48100ZN BATTERIES (5 OFF) IN RACK AT G000F03.
13. REPLACE EXISTING 32A 1P CB (3 OFF) WITH NEW 40A 1P CB (3 OFF) FOR OPTUS PSU ON THE DISTRIBUTION BOARD.
14. OPTUS POWER TOOL V12.7 APPROVED.
15. DIVERSIFY Tx FEEDS OVER 2 PSUs. APDP FEED A ON OPTUS PSU-1-O. FEED B ON VODAFONE PSU-2-V.

AC POWER UPGRADE:

16. EXISTING OPTUS 50A THREE PHASE POWER SUPPLY IS SUFFICIENT FOR THE PROPOSED UPGRADE.

VODAFONE NOTES:

17. REMOVE EXISTING VODAFONE HUAWEI BBU AND DCDU FROM THE RACK AT G001F02.
18. INSTALL NEW NOKIA AIRSCALE/AMID CHASIS 1 OFF WITH SUITABLE BB CARDS AS PER EBP IN RACK AT G001F02.
19. NOKIA AIRSCALE SHALL BE POWER UP VIA VODAFONE PSU IN RACK AT G000F04.
20. NOKIA TX ROUTER TO BE RELOACTED FROM RU7 TO RU18 OR HIGHER POSTION AT G000F02

iDCDP NOTES:


21. REUSE EXISTING VODAFONE 22-WAY LENMIC iDCDP (1 OFF) IN RACK AT G001F05. AND SWAP CBs ON PSU AND iDCDP AS PER LATEST GUIDELINE.

HYBRID CABLE NOTES:

22. REUSE EXISTING VODAFONE H&S 9/18 HYBRID CABLE (1 OFF) (LENGTH: 40m) AND INSTALL NEW H&S 9/18 (10mm²) HYBRID CABLES (1 OFF) (LENGTH: 40m)

DC POWER UPGRADE:

23. REMOVE EXISTING VODAFONE HUAWEI PSU (1 OFF) WITH EXISTING 3kW RECTIFIERS (6 OFF) AND LPFG12-100S BATTERY STRINGS (5 OFF) FROM THE RACK AT G000F04.
24. INSTALL NEW VODAFONE 27kW VERTIV PSU WITH NEW 3kW RECTIFIERS (6 OFF) AT G000F04.
25. INSTALL NEW LFeLi-48100ZN BATTERIES (5 OFF) IN RACK AT G000F04.
26. REPLACE EXISTING 32A 1P CB (3 OFF) WITH NEW 40A 1P CB (3 OFF) FOR VODAFONE PSU ON THE DISTRIBUTION BOARD.

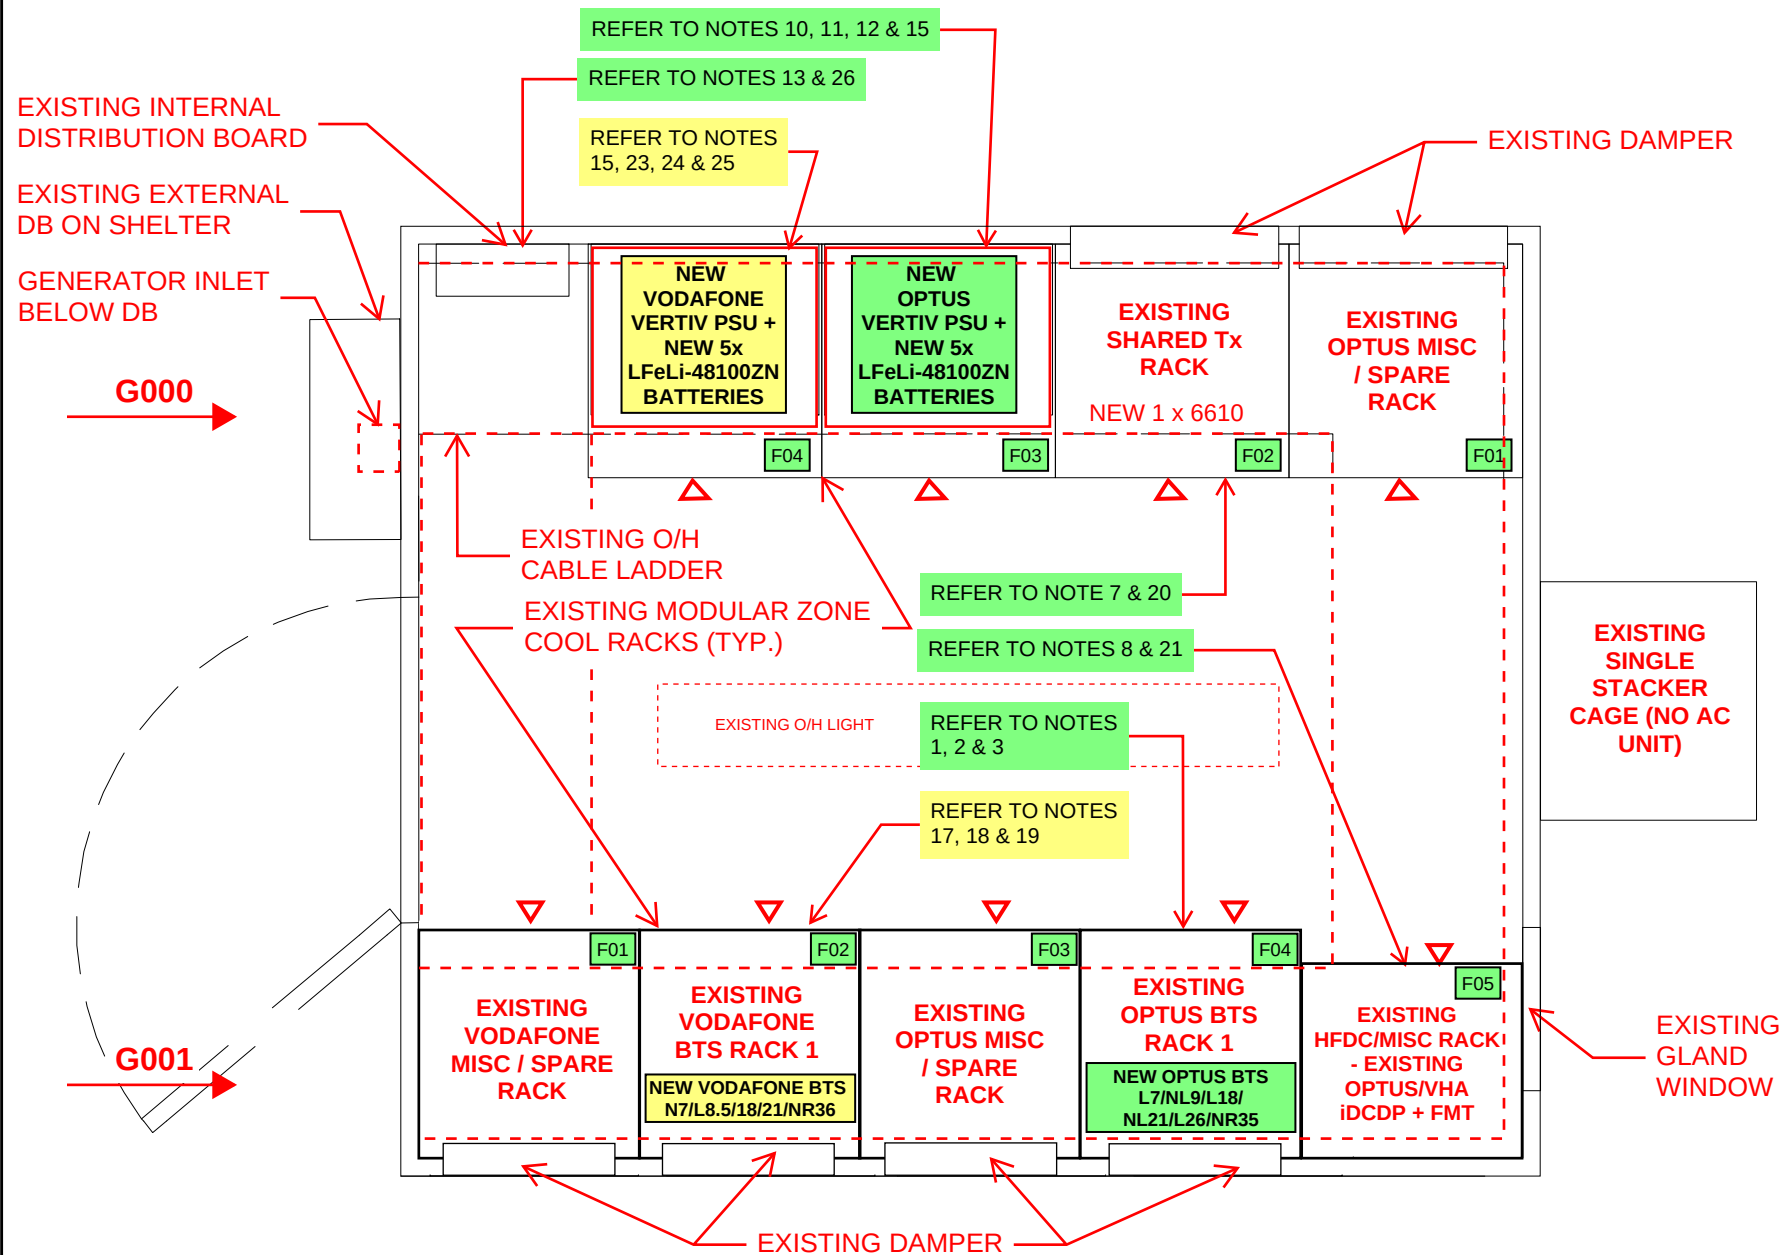

SHELTER LAYOUT PLAN

SCALE 1:20

A	13.09.25	ISSUED FOR CONSTRUCTION (SG UPGRADE (eJV))			ALL TELECOS	RN	SS	GL	JM
Rev	Date	Revision Details			Consultant	CAD	Designer	Verifier	Approver



Client:	
---------	--

Project:

MOBILE NETWORK
AUSTRALIA
SITE No:- H8097
AUSTINS FERRY

Drawing Title:

EQUIPMENT SHELTER LAYOUT PLAN

Drawing Status:

FOR CONSTRUCTION

Drawing No.

H8097-F1

Revision

A

