The yellow highlighted comments from Electrical Engineer, which needs to be included in DFC. Next sheet is latest Output DFC file

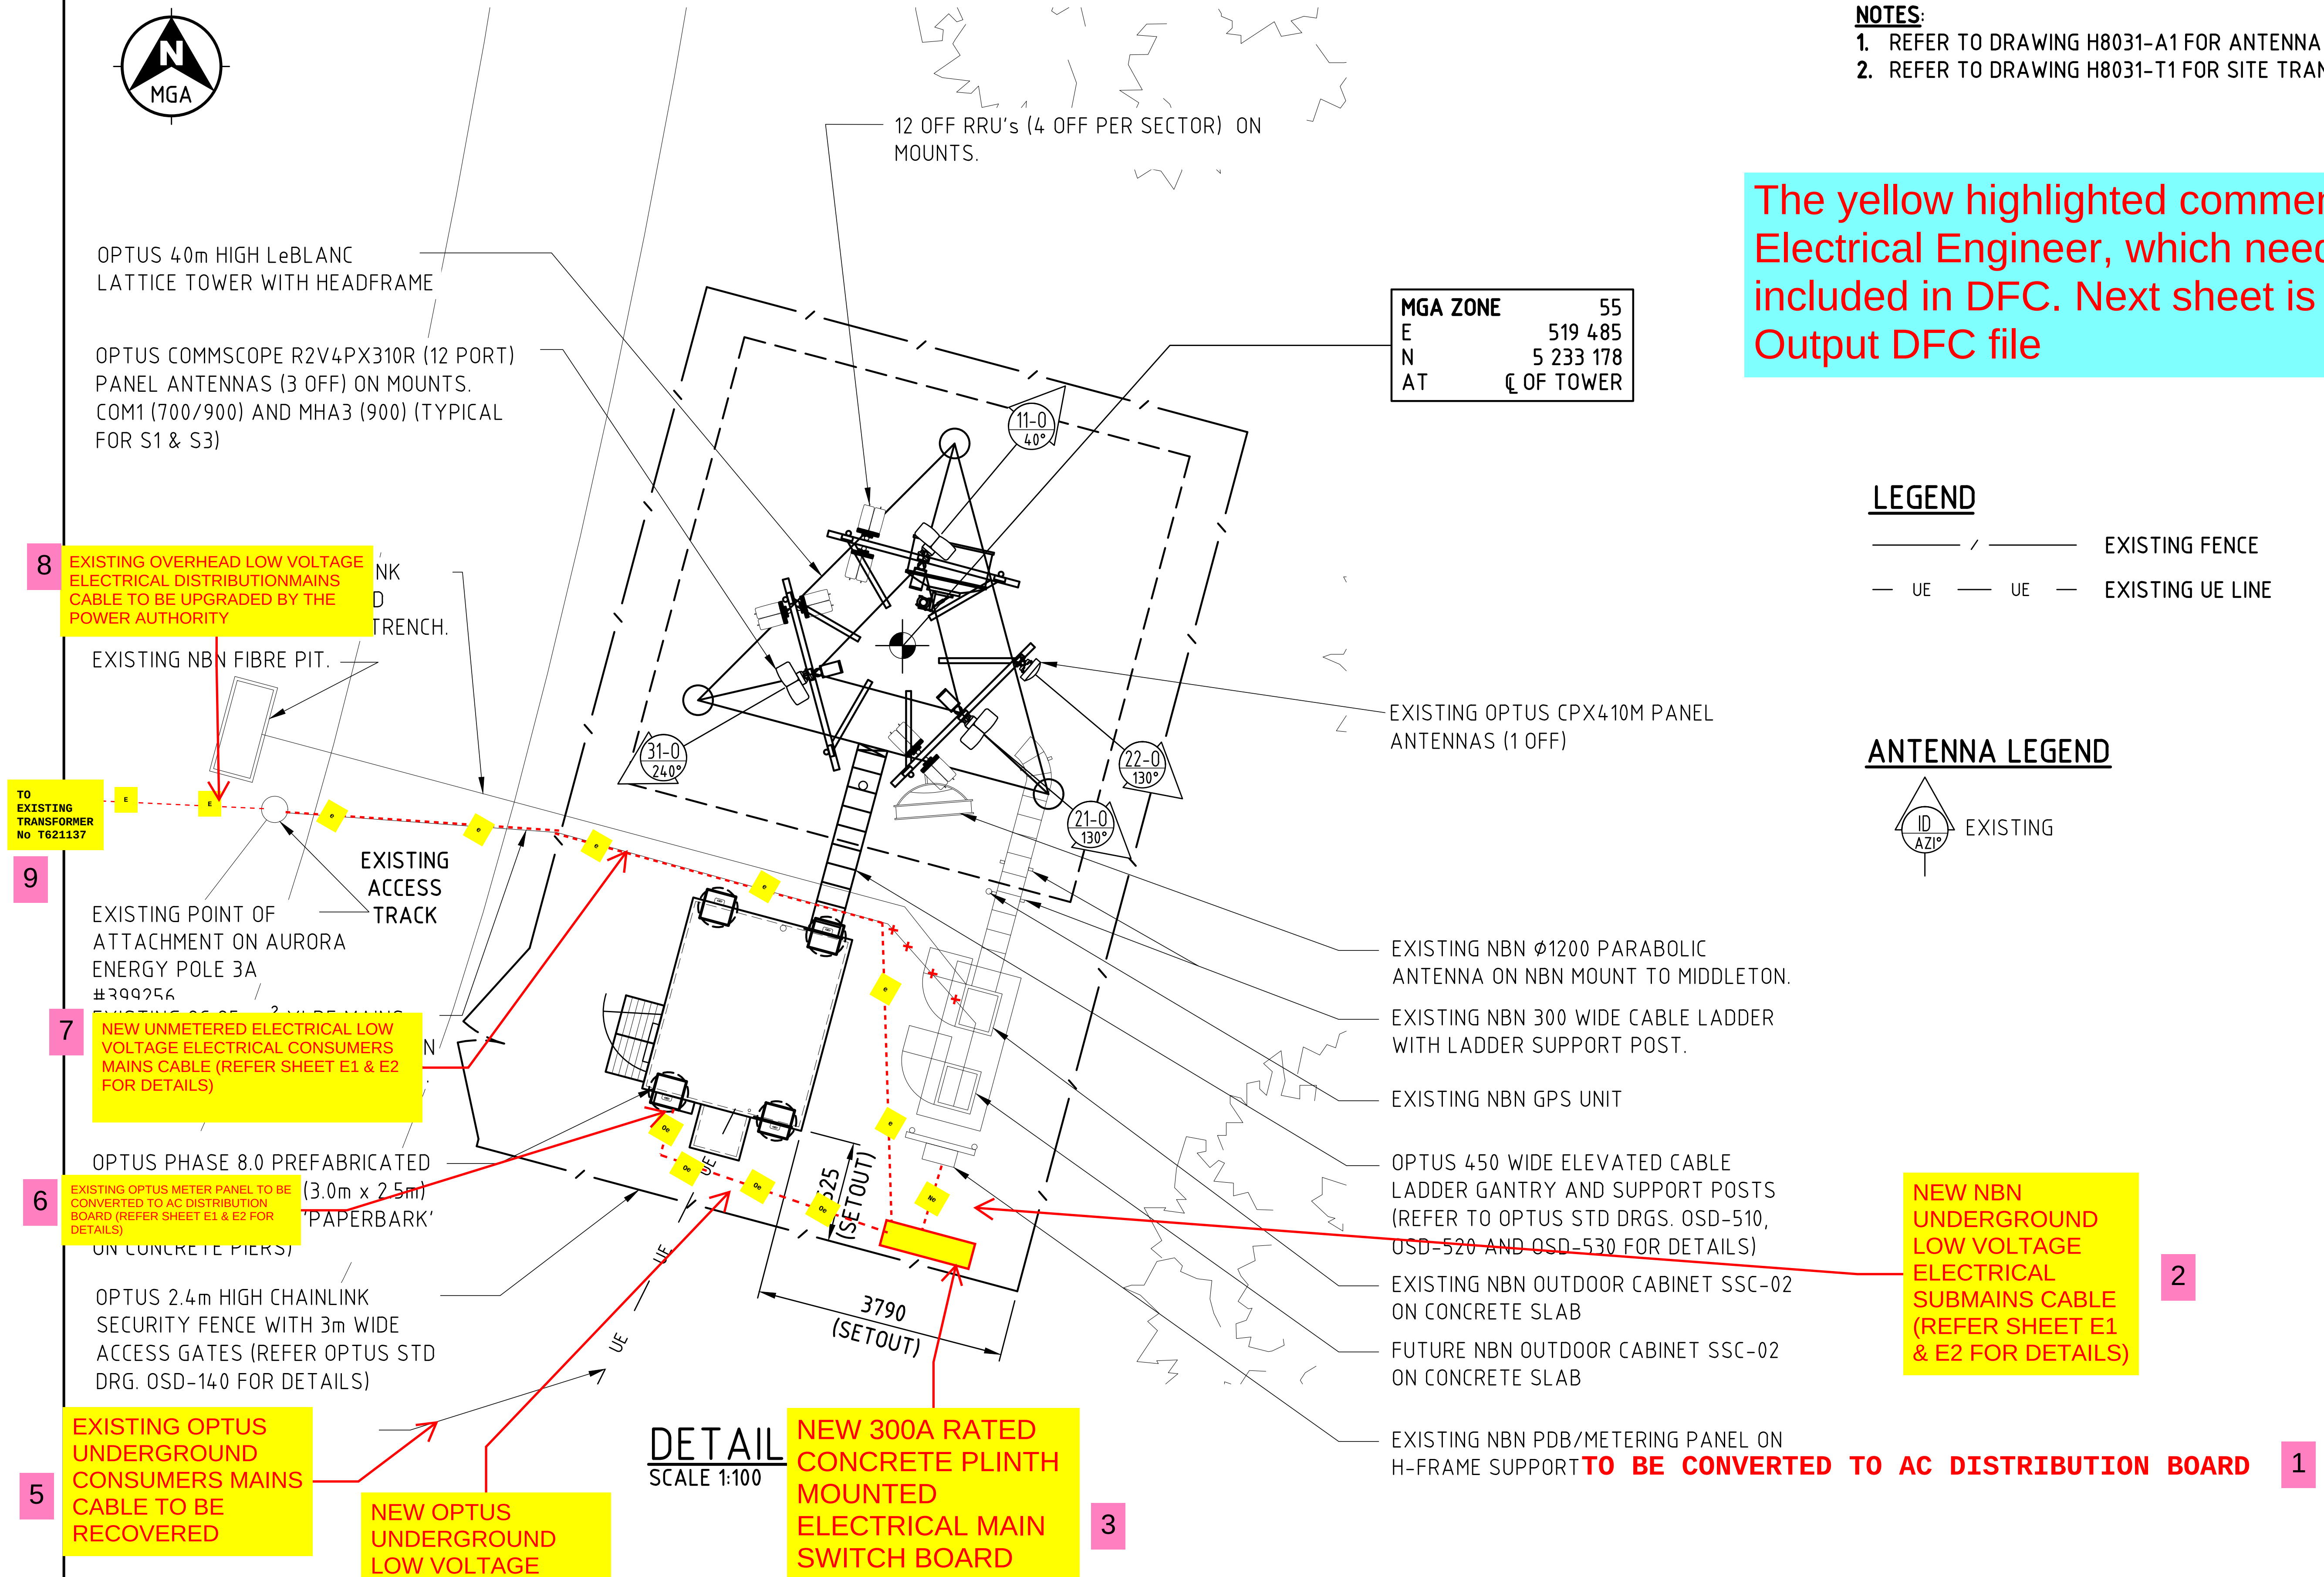

Rev	Date	Revision Details	Consultant	CAD	Designer	Verifier	Approver
AB	24.02.16	AS BUILT ISSUE (LTE RURAL UPGRAD				M	NR
C	15.09.14	ISSUED FOR CONSTRUCTION				H	AH
B	17.08.10	COMPOUND ROTATE TO MATCH LEASE	DI			DI	CT
A	26.11.09	FOR CONSTRUCTION	DI	SR		DI	CT
02	09.07.09	ANTENNA AND TABLE REVISED	DI	LR		DI	CT
01	24.03.09	PRELIMINARY ISSUE	DI	JM		DI	CT

VISIONSTREAM PTY LTD
25-37 Huntingdale Road
Burwood VIC 3125
Australia
Tel- +61 3 9273 7600
www.visionstream.com.au

Client: OPTUS yes

Project:
MOBILE NETWORK AUSTRALIA
SITE No:- H8031
SNUG
120 LONGMANS ROAD

Drawing Title:
SITE LAYOUT AND SETOUT PLAN

Drawing Status: AS BUILT

Drawing No. H8031-G3

Revision AB

20 10 0 10 20 30 40 50mm A3

CAD File C:\Users\ybian\Desktop\CAD CAD CAD CAD\H8031 SNUG_AB_V6.dwg Date 04.05.2017 1:26 PM latest Output DFC file

CONTRACTOR NOTE:
EXISTING HEADFRAME U-BOLTS WERE LOOSE/DAMAGED AT SEVERAL LOCATIONS. CONTRACTOR TO REPLACE WITH NEW U-BOLTS.

NOTES:

1. ALL ANTENNA ORIENTATIONS ARE IN DEGREE RELATIVE TO TRUE NORTH.
2. REFER TO DRG. H8031-A1, H8031-A2 AND H8031-A3 FOR ANTENNA SYSTEM CONFIGURATION.
3. REFER TO DRG. H8031-G1 FOR STRUCTURAL ASSESSMENT NOTES.
4. EXISTING CORRODED, DAMAGED OR MISSING ANTENNA MOUNT U-BOLTS AND FIXING TO BE REPLACED AS REQUIRED.
5. EXISTING OTHER CARRIER ANTENNAS ARE NOT SHOWN FOR CLARITY.

ANTENNA LEGEND

ID AZI° — NEW, REPLACE

LEGEND

- EXISTING FENCE LINE
- EXISTING O/H POWER SUPPLY
- NEW NBN U/G POWER LINE
- NEW U/G CONSUMERS MAINS
- NEW OPTUS U/G POWER LINE

N MGA

REPLACE EXISTING FADED KEEP OUT SIGNAGE ON EXISTING ACCESS GATE WITH NEW KEEP OUT SIGN

REPLACE EXISTING RFNSA NUMBER FADED MERCS-2 SIGN ON EXISTING ACCESS GATE WITH NEW MERCS-2 SIGN WITH CORRECT RFNSA NUMBER-7054003 HARD STAMPED

EXISTING INDARA 2.4m HIGH CHAINLINK SECURITY FENCE WITH 3m WIDE ACCESS GATE

EXISTING TREE LINE (TYP.)

EXISTING POWER POLE (POA) 3A #399256

9 TO EXISTING TRANSFORMER No T621137

8 EXISTING OVERHEAD LOW VOLTAGE ELECTRICAL DISTRIBUTION MAINS CABLE TO BE UPGRADED BY THE POWER AUTHORITY

7 NEW UNMETERED ELECTRICAL LOW VOLTAGE ELECTRICAL CONSUMERS MAINS CABLE (REFER SHEET H8031-E1 & E2 FOR DETAILS)

EXISTING NBN FIBRE PIT

REUSE EXISTING VODAFONE H&S 6/12 HYBRID CABLES (3 OFF) (LENGTH IS 60m) (CHECK CONDUCTOR SIZE DURING CONSTRUCTION. IF THE TRUNK CABLE IS 6mm2, INSTALL Y-JUMPERS FOR AAU AVQL. IF THE EXISTING TRUNK CABLE IS 10mm2, NO Y-JUMPERS REQUIRED) RUN IN EXISTING OPTUS 450 WIDE ELEVATED CABLE LADDER

REMOVE EXISTING OPTUS AVA5-50 FEEDERS (6 OFF). REUSE EXISTING OPTUS H&S 9/18 HYBRID CABLES (2 OFF) (LENGTH IS 50m) RUN IN EXISTING OPTUS 450 WIDE ELEVATED CABLE LADDER

INSTALL NEW VODAFONE NOKIA AYGE GPS ANTENNA (1 OFF) ON TOP OF EQUIPMENT SHELTER WALL NEAR GLAND WINDOW

REMOVE EXISTING WORN-OUT SIGNS ON OPTUS SHELTER DOOR AND INSTALL NEW OPTUS SITE ENQUIRY SIGN ON SHELTER DOOR

EXISTING OPTUS PHASE 8.0 SANDWICH PANEL SHELTER (3.0m x 2.5m) ON CONCRETE PIERS TO BE RECONFIGURED TO ACCOMMODATE EXISTING AND NEW OPTUS/VODAFONE EQUIPMENT'S. REFER TO DRG. H8031-F1 FOR EQUIPMENT SHELTER LAYOUT DETAILS

6 EXISTING OPTUS METER PANEL TO BE CONVERTED TO AC DISTRIBUTION BOARD (REFER SHEET E1 & E2 FOR DETAILS)

REPLACE EXISTING OUTDATED HAZARDOUS VOLTAGE SIGN ON OPTUS SHELTER PANEL BOX WITH NEW DANGER HAZARDOUS VOLTAGE SIGN

5 EXISTING OPTUS UNDERGROUND CONSUMERS MAINS CABLE TO BE RECOVERED

4 NEW OPTUS UNDERGROUND LOW VOLTAGE ELECTRICAL SUBMAINS CABLE (REFER SHEET H8031-E1 & E2 FOR DETAILS)

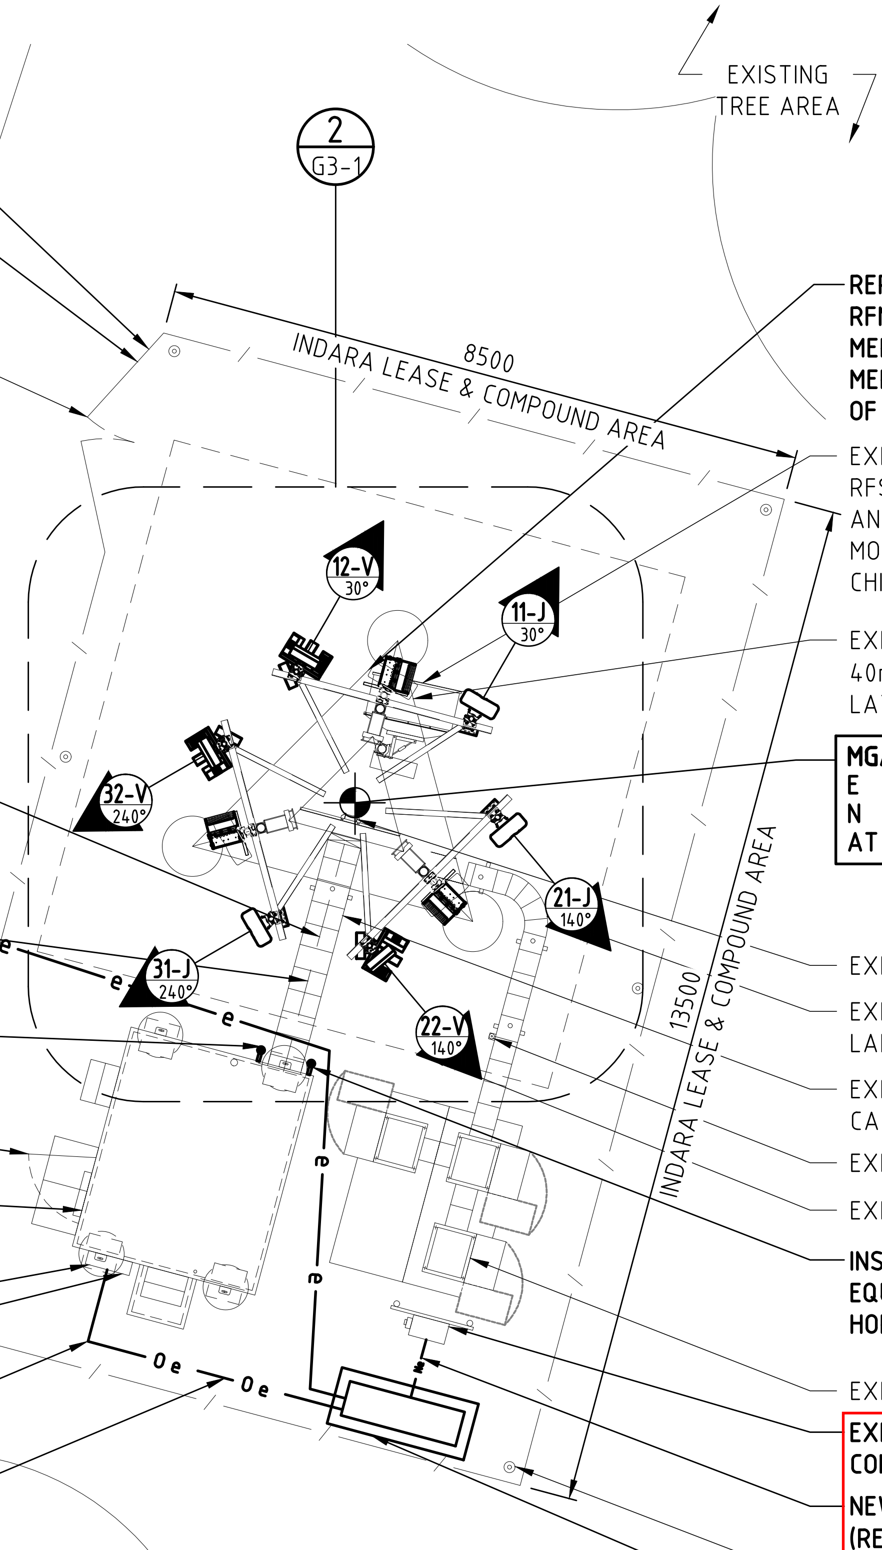

REPLACE EXISTING RFNSA WEBSITE FADED MERCS-1 SIGN WITH NEW MERCS-1 SIGN AT BASE OF TOWER

EXISTING OPTUS ø1200 RFS PARABOLIC ANTENNA ON LEG MOUNT TO H0005 CHIMNEY POT

EXISTING INDARA 40m HIGH (LeBLANC) LATTICE TOWER

MGA ZONE	55
E	519 487
N	5 233 177
AT ℄ LATTICE TOWER	

EXISTING CLIMBING LADDER WITH TWIN LANYARD TO THE TOWER

EXISTING NBN 300mm WIDE CABLE LADDER WITH LADDER SUPPORT POST

EXISTING OPTUS 450mm WIDE ELEVATED CABLE LADDER GANTRY AND SUPPORT POST

EXISTING NBN GPS ANTENNA

EXISTING TOWER FOUNDATION

INSTALL NEW OPTUS ERICSSON GNSS GPS ANTENNA (1 OFF) ON TOP OF EQUIPMENT SHELTER WALL NEAR GLAND WINDOW. ENSURE MIN. 500mm HORIZONTAL SEPARATION FROM OTHER GPS ANTENNA

EXISTING NBN ODU ON CONCRETE SLAB

EXISTING NBN PDB/METERING PANEL ON H-FRAME SUPPORT TO BE CONVERTED TO AC DISTRIBUTION BOARD 1

NEW NBN UNDERGROUND LOW VOLTAGE ELECTRICAL SUBMAINS CABLE (REFER SHEET H8031-E1 & E2 FOR DETAILS) 2

EXISTING EARTH PIT (TYP.)

NEW 300A RATED CONCRETE PLINTH MOUNTED ELECTRICAL MAIN SWITCH BOARD (REFER SHEET H8031-E1 & E2 FOR DETAILS) 3

DETAIL 1 / G2
SCALE 1:100

Rev	Date	Revision Details	Consultant	CAD	Designer	Verifier	Approver
A	29.10.25	ISSUED FOR CONSTRUCTION (UPGRADE 5G (eJV))	ALL TELECOS	RM	SA	GL	JM
AB	08.12.21	AS BUILT (TX UPGRADE PROJECT)	KORDIA	RL	--	--	--
AB	27.02.18	AS BUILT	CATALYST	JM	JF	DI	KM
A	28.10.16	PANEL ANTENNAS AND RRUS ADDED	DALY	HC	JF	DI	KM
AB	24.02.16	AS BUILT ISSUE (LTE RURAL UPGRADE)	VPL	RS	AST	MM	NR
C	15.09.14	ISSUED FOR CONSTRUCTION	TASC	BE	AST	AH	AH
B	17.08.10	COMPOUND ROTATE TO MATCH LEASE PLAN	DI	JM		DI	CT
A	26.11.09	FOR CONSTRUCTION	DI	SR		DI	CT
02	09.07.09	ANTENNA AND TABLE REVISED	DI	LR		DI	CT

CPS TECHNOLOGY & INFRASTRUCTURE

Client: OPTUS

Project: MOBILE NETWORK AUSTRALIA
SITE No:- H8031
SNUG
120 LONGMANS ROAD

Drawing Title: SITE LAYOUT AND SETOUT PLAN

Drawing Status: FOR CONSTRUCTION

Drawing No. H8031-G3

Revision A

20 10 0 10 20 30 40 50mm A3

ELECTRICAL AND EARTHING SPECIFICATION

CHECK E1 sheets based on EE Markup

1. GENERAL

ALL ELECTRICAL WORKS SHALL BE IN ACCORDANCE:

- LATEST OPTUS D&C SPECIFICATIONS
- AS/NZ 3000:2018, AS/NZ 3008, AS/NZ 1768, AS/NZ3015 (LATEST EDITIONS AND AMENDMENTS AT TIME OF CONSTRUCTION SHALL APPLY)
- TAS NETWORKS SERVICE AND INSTALLATION RULES

CONTRACTOR TO ENSURE FAULT CURRENT RATINGS OF PROTECTIVE EQUIPMENT INSTALLED ARE ADEQUATE FOR PROSPECTIVE FAULT LEVELS.

CABLE ROUTES SHALL BE AS DIRECT AS POSSIBLE. WHERE CABLE TURNS ARE REQUIRED, THE RADIUS OF ANY BENDS SHALL NOT BE LESS THAN THE MINIMUM BENDING RADIUS OF THE CABLE.

ALL EXPOSED CABLE, CONDUITS AND NON-METALLIC FASTENERS SHALL BE UV RESISTANT AND SHALL BE ADEQUATELY SECURED TO SURFACE, CABLE TRAY OR STRUCTURE.

CONTRACTOR SHALL MAKE THEMSELVES AWARE OF ALL SERVICES PRESENT ON SITE AND OF ALL SITE CONDITIONS AND SAFETY REQUIREMENTS PRIOR TO COMMENCING WORK ON SITE.

2. OPTUS SUPPLY OF ELECTRICITY

EXISTING OPTUS AC POWER CAPACITY ON THE SITE IS 63A SINGLE PHASE 415V AND IT REQUIRES TO BE UPGRADED TO 150A 1-PHASE AS PART OF PROPOSED 5G AUGMENTATION WORKS.

150A 1-PHASE SUPPLY SERVICE FOR OPTUS SHALL BE TAKEN FROM THE NEW UPGRADED ELECTRICAL MAIN SWITCH BOARD TO BE INSTALLED INSIDE THE TELCO COMPOUND AS SHOWN ON SHEET E2 AND G2.

UPGRADED SITE ELECTRICAL MAIN SWITCH BOARD AC POWER WILL BE SUPPLIED FROM THE EXISTING POWER AUTHORITY POWER POLE No 399256 AS SHOWN ON SHEET G2 AND E2.

3. DISTRIBUTION MAINS CABLE

CURRENTLY ON THE SITE 2 x 1c x 25mm^2 Al/ABC/XLPE OVERHEAD LOW VOLTAGE DISTRIBUTION MAINS CABLE IS INSTALLED BETWEEN THE EXISTING POLE MOUNTED 50kVA SINGLE PHASE TRANSFORMER No T 62 1137 AND THE POWER AUTHORITY POLE No 399256 AS SHOWN ON SHEET E2 AND G2.

EXISTING OVERHEAD LOW VOLTAGE DISTRIBUTION MAINS CABLE TO BE UPGRADED BY THE POWER AUTHORITY. THIS SECTION WILL BE UPDATED ONCE POWER APPROVAL IS RECEIVED FROM THE POWER AUTHORITY.

4. CONSUMERS MAINS CABLE

CURRENTLY 2 x 1c x 16mm^2 Cu/XLPE UGOH UNMETERED OPTUS CONSUMERS MAINS CABLE IS INSTALLED BETWEEN THE EXISTING POWER AUTHORITY POLE No 399256 AND THE EXISTING OPTUS SHELTER EXTERNAL MOUNTED METER PANEL.

CURRENTLY 2 x 1c x 16mm^2 Cu/XLPE UGOH UNMETERED NBN CONSUMERS MAINS CABLE IS INSTALLED BETWEEN THE EXISTING POWER AUTHORITY POLE No 399256 AND THE EXISTING NBN H-FRAME MOUNTED METER PANEL.

ELECTRICIAN ON THE SITE SHALL DISCONNECT AND RECOVER BOTH OPTUS AND NBN INSTALLED CONSUMERS MAINS CABLE.

ELECTRICIAN ON THE SITE SHALL PROVIDE AND INSTALL NEW 2 x 1c x 95mm^2 Cu/XLPE/PVC UGOH ON THE EXISTING POLE No 399256 WITHIN NEW 63mm HD uPVC CONDUIT AND SHALL TERMINATE INTO NEW TELCO COMMON ELECTRICAL MAIN SWITCH BOARD AS SHOWN ON SHEET E2.

5. MAIN SWITCH BOARD

ELECTRICIAN ON THE SITE SHALL INSTALL NEW MINIMUM 300A RATED CONCRETE PLINTH MOUNTED ELECTRICAL MAIN SWITCH BOARD AS SHOWN ON SHEET G2 AND E2.

ELECTRICIAN ON THE SITE SHALL PROVIDE AND INSTALL BELOW LISTED NEW ELECTRICAL SWITCH GEARS WITHIN NEW TELCO ELECTRICAL MAIN SWITCH BOARD:

- NEW SUITABLE SIZE BUSBARS OR ACTIVE/NEUTRAL LINKS TO TERMINATE 95mm^2 CONSUMERS MAINS CABLE
- NEW 250A 1-POLE MCCB SERVICE PROTECTION DEVICE WITH TRIP CURRENT SETTING SET AT 230A
- NEW UNMETERED ACTIVE AND NEUTRAL LINKS
- NEW 150A 1-POLE FOR OPTUS AS METER PROTECTION DEVICE
- NEW SINGLE PHASE CURRENT TRANSFORMER METERING EQUIPMENT FOR OPTUS
- NEW 150A 1-POLE MCB C-CURVE FOR OPTUS
- RELOCATE EXISTING NBN SERVICE FUSE FROM ITS METER PANEL TO NEW ELECTRICAL MAIN SWITCH BOARD
- RELOCATED EXISTING NBN SINGLE PHASE METER
- INSTALL NEW 80A 1-POLE MCB FOR NBN
- NEW MEN LINKS AND EARTH ELECTRODE

ELECTRICIAN SHALL DECOMMISSION EXISTING OPTUS SINGLE PHASE METER FROM THE EXISTING METER PANEL. ALL EXISTING MULTIPLE MEN CONNECTIONS ON THE SITE SHALL BE RECOVERED.

** NOTE - TEMPORARY SUITABLE SIZE GENERATORS WILL BE REQUIRED FOR THE EXISTING OPTUS SHELTER AND NBN UNTIL THE ELECTRICAL UPGRADE WORKS ARE COMPLETED. ELECTRICIAN SHALL NOTIFY TO NBN/OPTUS ABOUT THE PROPOSED AC UPGRADE WORKS BEFORE STARTING ANY WORKS ON THE SITE.
ELECTRICIAN SHALL GET NEW ELECTRICAL MAIN SWITCH BOARD DRAWINGS FROM THE MSB MANUFACTURER AND SHALL SUBMIT TO THE POWER AUTHORITY INSPECTOR FOR AN APPROVAL BEFORE MANUFACTURING THE NEW MSB.

6. SUBMAINS CABLE

EXISTING NBN UNDERGROUND SUBMAINS CABLES SHALL BE FULLY RECOVERED.

ELECTRICIAN SHALL PROVIDE AND INSTALL NEW 1 x 2c x 35mm^2 Cu/XLPE + E MULTICORE SUBMAINS CABLE WITHIN NEW 63mm HD CONDUIT FOR OPTUS BETWEEN THE NEW ELECTRICAL MAIN SWITCH BOARD AND OPTUS SHELTER MOUNTED EXTERNAL DISTRIBUTION BOARD AS SHOWN ON SHEET E2.

ELECTRICIAN SHALL PROVIDE AND INSTALL NEW 1 x 2c x 16mm^2 Cu/XLPE + E MULTICORE SUBMAINS CABLE WITHIN NEW 63mm HD CONDUIT FOR NBN BETWEEN THE NEW ELECTRICAL MAIN SWITCH BOARD AND EXISTING NBN H-FRAME MOUNTED EXTERNAL DISTRIBUTION BOARD AS SHOWN ON SHEET E2.

7. APPLICATION FOR CONNECTION

AN APPLICATION FOR CONNECTION TO THE POWER AUTHORITY IS SUBMITTED AND REFERENCE NUMBER IS CN25-154601. THIS SECTION WILL BE UPDATED ONCE SOME RESPONSE IS RECEIVED BACK FROM THE POWER AUTHORITY.

8. ISOLATOR SWITCH

ELECTRICIAN SHALL UPGRADE THE EXISTING OPTUS ISOLATOR SWITCH INSTALLED WITHIN OPTUS SHELTER EXTERNAL AC DB WITH NEW 150A 1-POLE ISOLATOR SWITCH AS SHOWN ON SHEET E2.

9. LABELING

FIX STANDARD LABELS TO ALL FUSE, METER AND SWITCH POSITIONS IN METER ENCLOSURE LABELS TO BE BLACK LETTERING ON WHITE BACKGROUND "TRAFFOLYTE". LETTERING TO BE MINIMUM 10mm HIGH. TEXT TO READ "OPTUS" , "NBN". PROVIDE A PERMANET SKETCH PLAN IN THE NEW GROUP METERING ENCLOSURE AND OPTUS EXTERNAL SHELTER MOUNTED AC DB INDICATING THE SIZE AND DIRECTION OF THE SERVICES.

10. EARTHING

RRU'S AND AAU's SHALL BE INDIVIDUALLY EARTHED AS PER OPTUS AND MANUFACTURER'S SPECIFICATIONS. UTILISE EXISTING EARTHING POINTS ON MOUNTING ARRANGEMENT IF CAPACITY EXISTS OTHERWISE PROVIDE AND INSTALL NEW EARTH PLATES. ALL EARTHING CONNECTIONS TO BE VIA SINGLE HOLE LUG AS PER OPTUS GUIDELINES.

11. GENERATOR SUPPLY

GENERATOR INLET SOCKET IS LOCATED ON OPTUS SHELTER. REFER TO OSD-620 FOR MANUAL CHANGEOVER SWITCH DETAILS. CONTRACTOR IS TO ENSURE THAT ALL EQUIPMENT AND WIRING ARE INSTALLED AND CONFIGURED COMPLIANT WITH AS/NZ 3010 FOR ALTERNATE GENERATOR SUPPLY.

Rev	Date	Revision Details	Consultant	CAD	Designer	Verifier	Approver
A	29.10.25	ISSUED FOR CONSTRUCTION (UPGRADE 5G (eJV))	ALL TELECOS	RM	SA	GL	JM
AB	27.02.18	AS BUILT	CATALYST	JM	JF	DI	KM
A	28.10.16	NOTES AMENDED	DALY	HC	JF	DI	KM
A	26.11.09	FOR CONSTRUCTION	DI	SR		DI	CT

CPS TECHNOLOGY & INFRASTRUCTURE

Client: OPTUS

Project: MOBILE NETWORK AUSTRALIA
SITE No:- H8031
SNUG
120 LONGMANS ROAD

Drawing Title: ELECTRICAL SPECIFICATIONS

Drawing Status: FOR CONSTRUCTION

Drawing No. H8031-E1

Revision A

20 10 0 10 20 30 40 50mm A3

CABLE SCHEDULE

CABLE	CABLE TYPE	CORES	ACTIVE	NEUTRAL	EARTH	CABLE LENGTH	INSTALLATION METHOD	COMMENTS
A	XLPE/Cu	2 x 1c	95mm²	95mm²	-	40m	UGOH WITHIN NEW 63mm CONDUIT	BY OPTUS CONTRACTOR
B	XLPE/CU/ MULTICORE	1 x 2c + E	35mm²	35mm²	10mm²	10m	UNDERGROUND WITHIN NEW 63mm CONDUIT	BY OPTUS CONTRACTOR
C	XLPE/CU/ MULTICORE	1 x 2c + E	16mm²	16mm²	6mm²	6m	UNDERGROUND WITHIN NEW 63mm CONDUIT	BY OPTUS CONTRACTOR

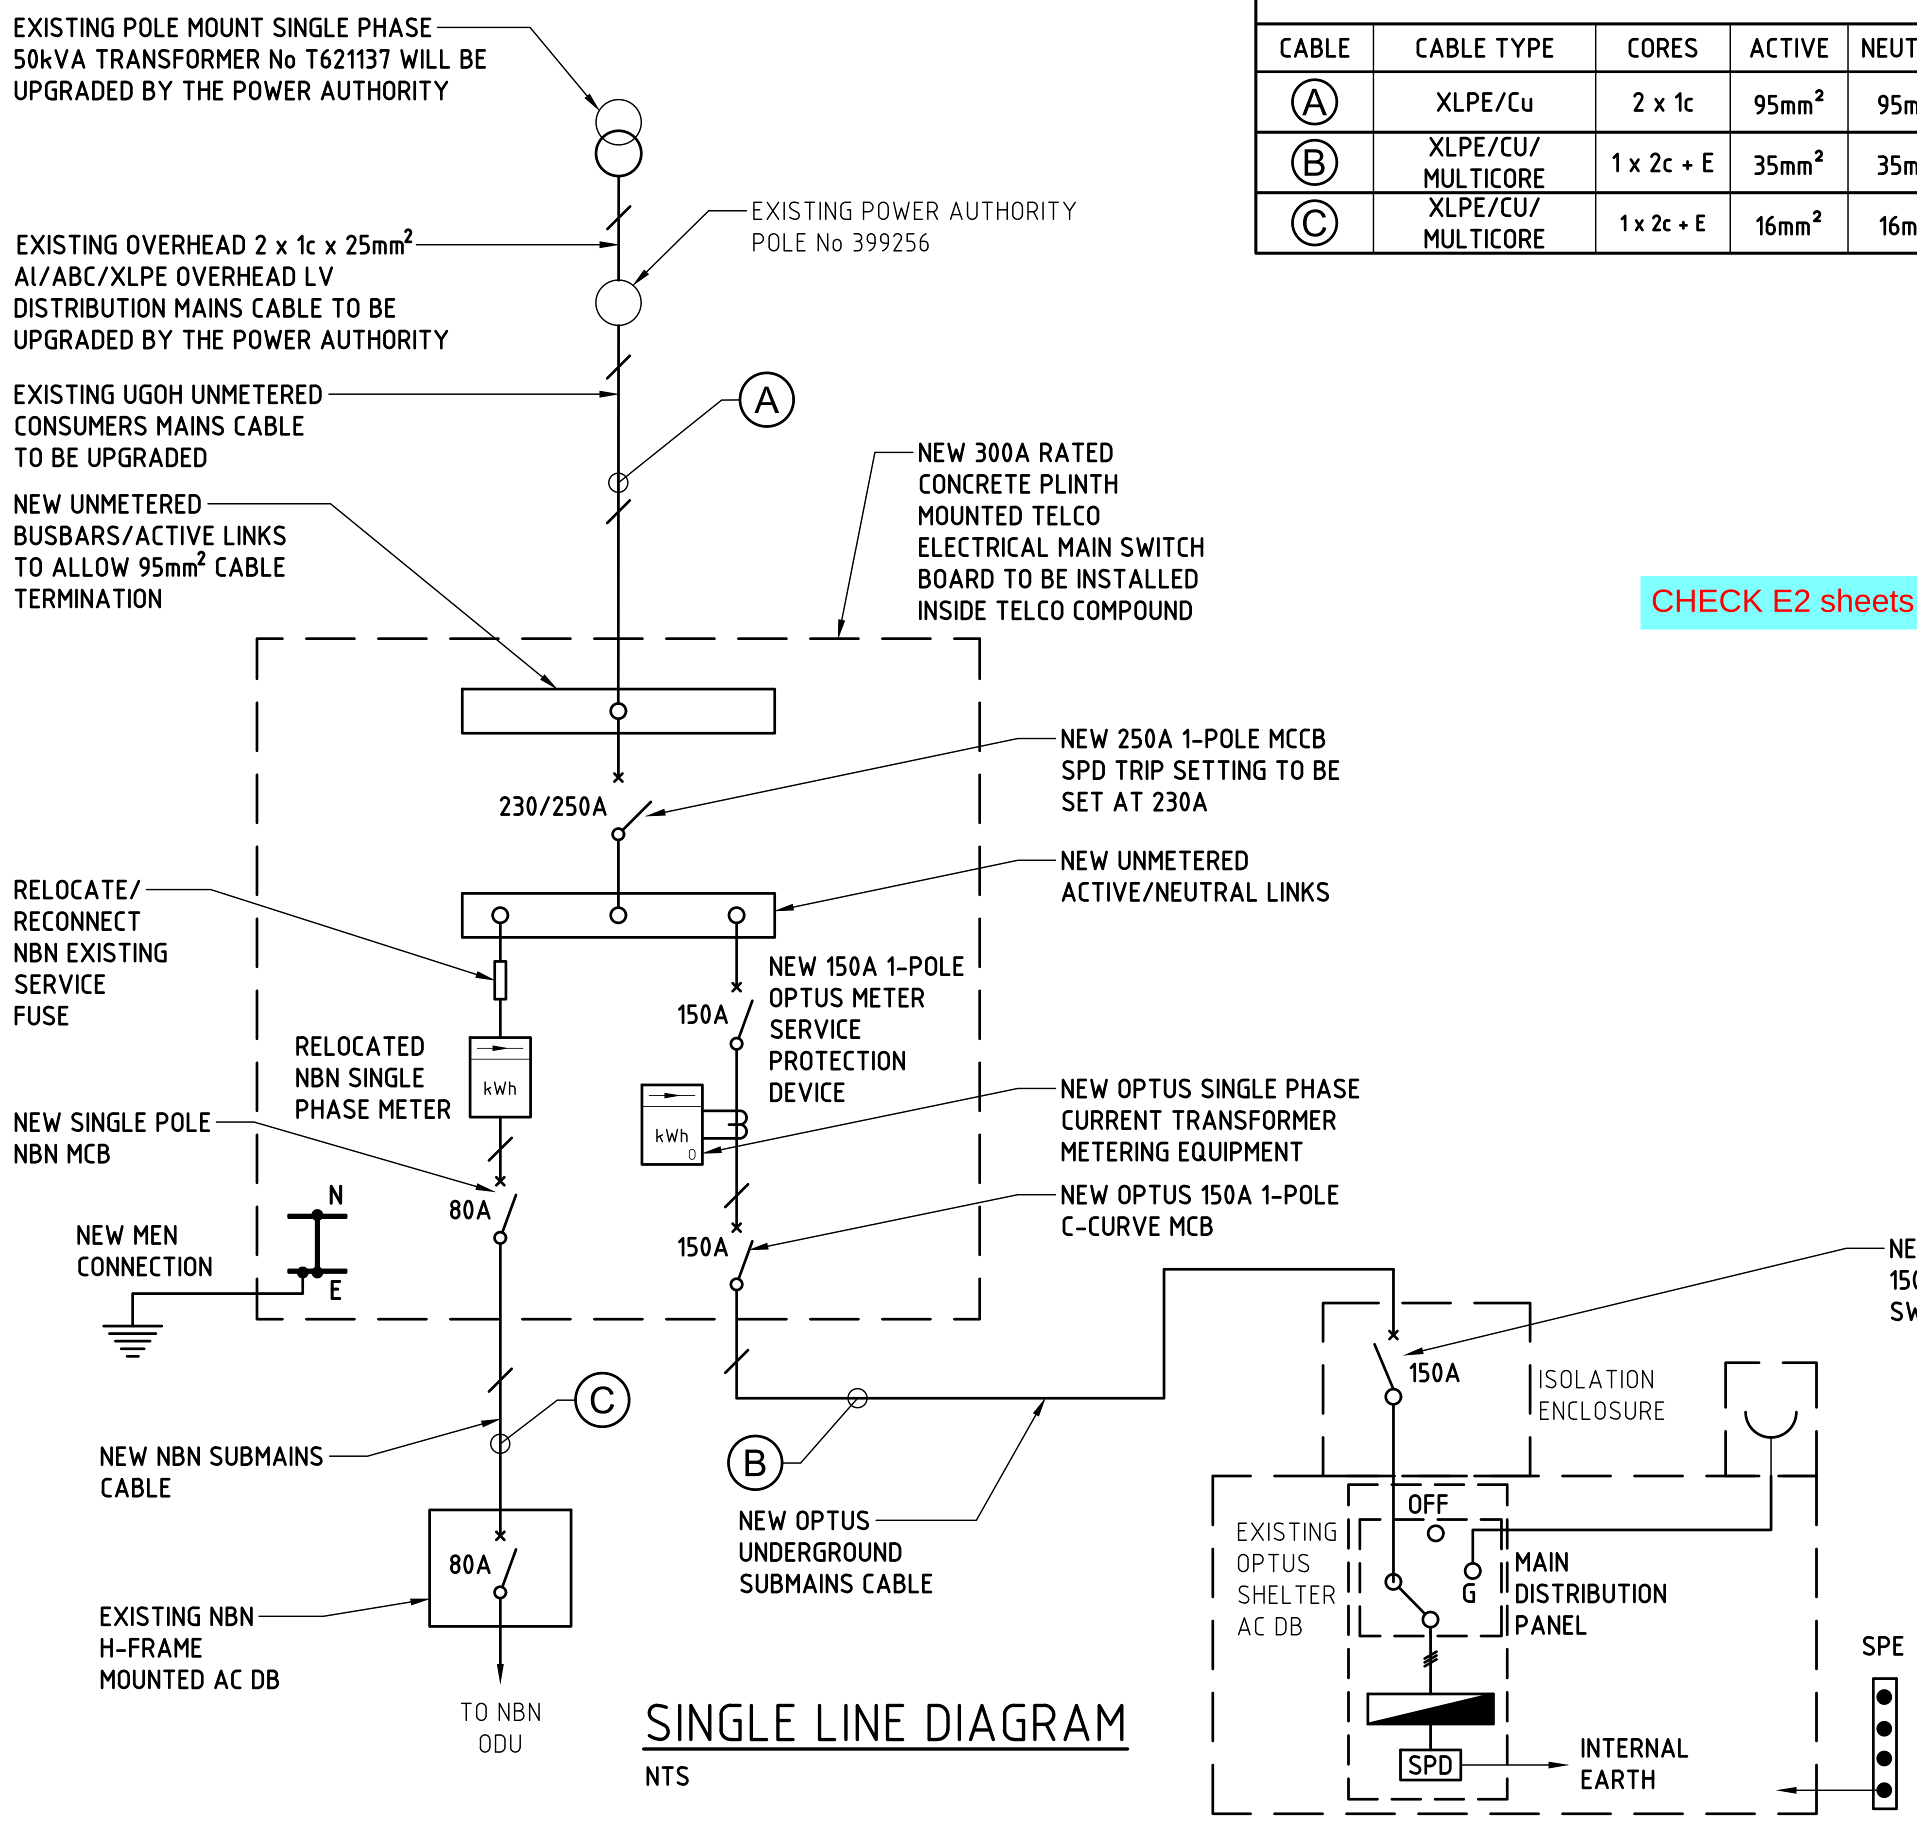

SINGLE LINE DIAGRAM

NTS

CHECK E2 sheets based on EE Markup

LEGEND

- SPE — SINGLE POINT EARTH CONNECTION (OPTUS)
- MSCB — MAIN SWITCH CIRCUIT BREAKER
- MEN — MULTIPLE EARTHED NEUTRAL
- METER
- CIRCUIT BREAKER
- ISOLATOR SWITCH
- DISTRIBUTION BOARD
- ISOLATION LINKS
- DENOTES NUMBER OF PHASES
- SURGE PROTECTION DEVICE
- MANUAL CHANGEOVER SWITCH (OFF, GEN)
- GENERATOR SOCKET INLET
- EARTH BAR/ NEUTRAL BAR
- FUSE
- EARTH CONNECTION

NOTES:

1. THIS DRAWING TO BE READ IN CONJUNCTION WITH H8031-E1.
2. CABLE LENGTHS GIVEN ARE INDICATIVE ONLY. EXACT CABLE ROUTES AND LENGTHS SHALL BE CONFIRMED ON SITE PRIOR TO CONSTRUCTION.

Rev	Date	Revision Details	Consultant	CAD	Designer	Verifier	Approver
A	29.10.25	ISSUED FOR CONSTRUCTION (UPGRADE 5G (eJV))	ALL TELECOS	RM	SA	GL	JM

CPS TECHNOLOGY & INFRASTRUCTURE

Client: OPTUS

Project: MOBILE NETWORK AUSTRALIA SITE No:- H8031 SNUG 120 LONGMANS ROAD

Drawing Title: SINGLE LINE DIAGRAM

Drawing Status: FOR CONSTRUCTION

Drawing No. H8031-E2

Revision A

20 10 0 10 20 30 40 50mm A3